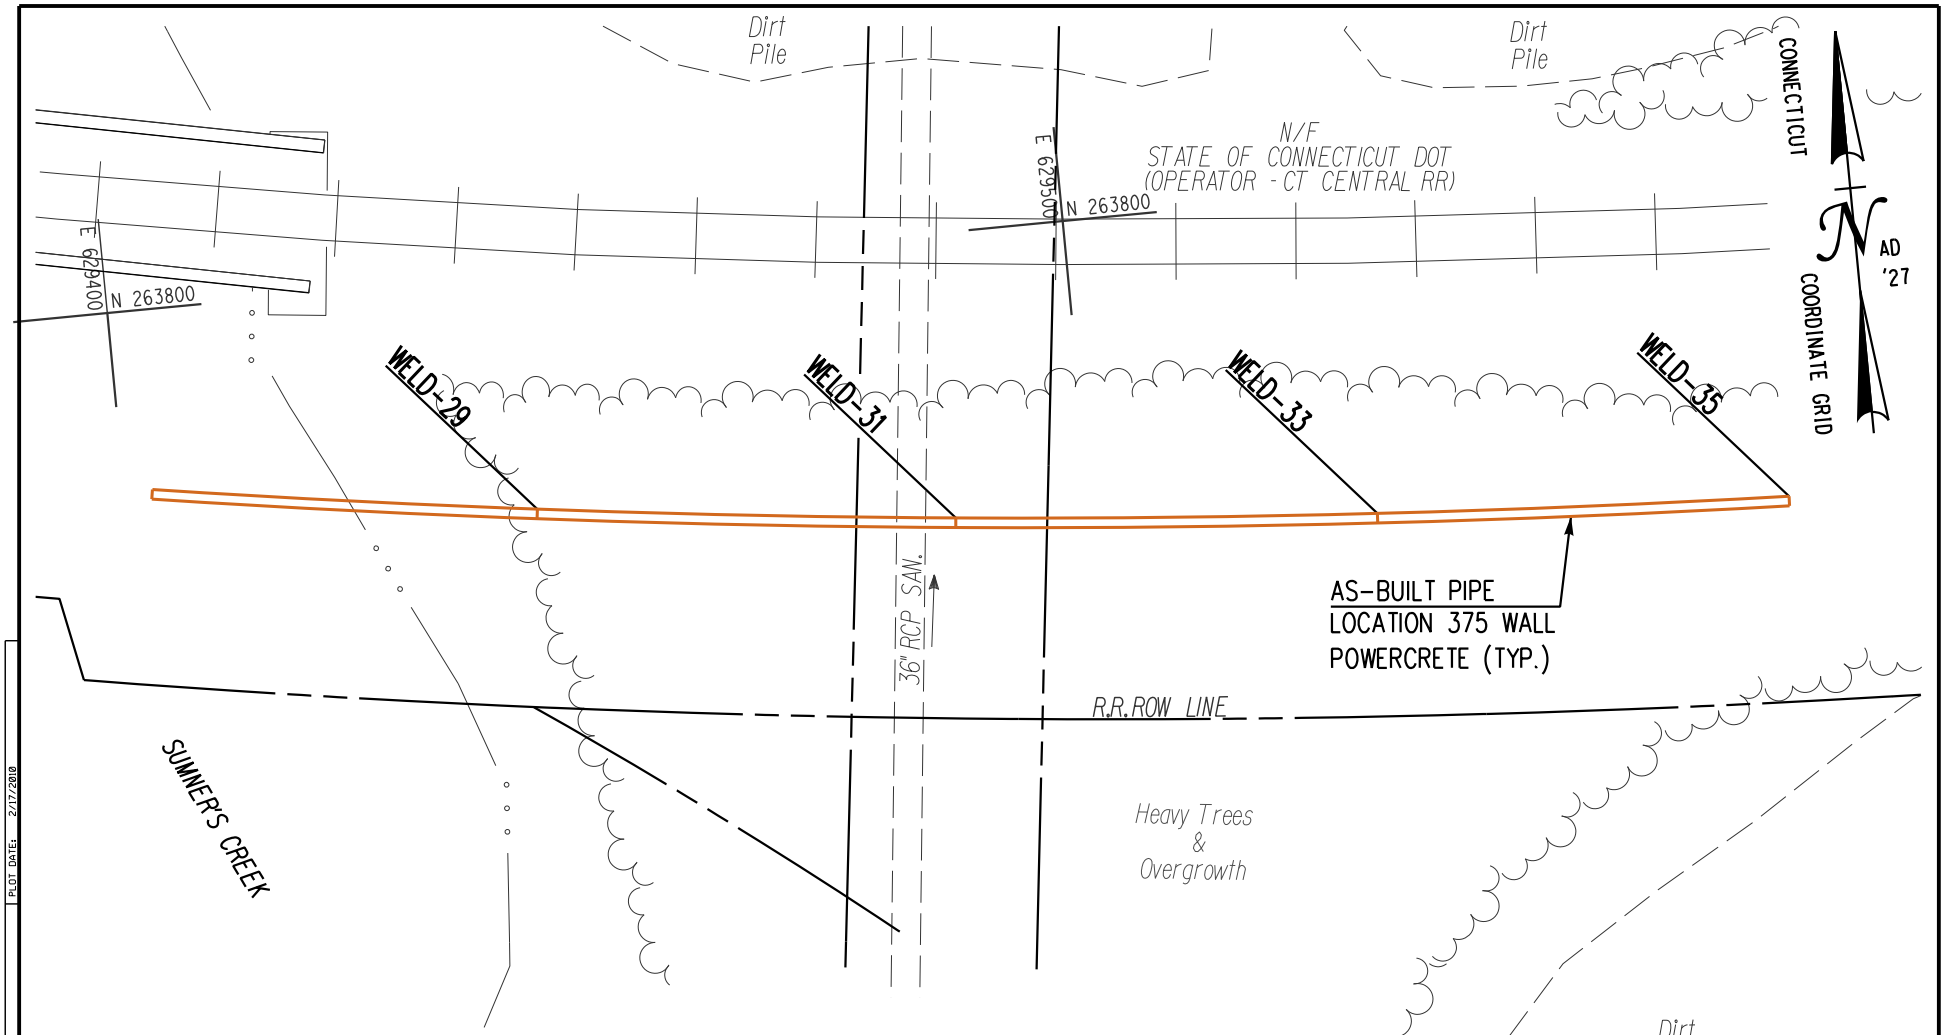


| Desc. | Station | Elev. | Northing | Easting |
|---|---|---|---|---|
| WELD-29 | 60+21.62 | -78.45 | 263774.88 | 629442.58 |
| WELD-31 | 60+65.25 | -74.31 | 263769.79 | 629485.91 |
| WELD-33 | 61+09.19 | -69.01 | 263766.04 | 629529.69 |
| WELD-35 | 61+52.13 | -62.75 | 263763.71 | 629572.56 |

Notes:
1. Elevations are based on NGVD 1929.
2. Stations refer to horiz. distances along pipeline from Middletown Junction.

1"=20'
SCALE IN FEET
20 0 20

AB-36

AS-BUILT SURVEY

| | |
|---|---|
| DATE OF SURVEY: | AUG. TO DEC. 2009 |
| DRAWN: | DJF |
| CHECKED: | PLW |
| DATE: | FEB., 2010 |
| SCALE: | AS SHOWN |
| UIC NO.: | 1255 A |


United International Corporation
Engineers and Surveyors
35 Thorpe Avenue, Suite 102, Wallingford, CT
Ph: (203)269-2993 Fax: (203)269-4395


BUCKEYE PARTNERS, L.P.

KLEEN ENERGY ULSD DELIVERY PIPELINE
12" RW999KN
MIDDLETOWN, CONNECTICUT

RIVER ROAD

CONSULTANT FILE NAME: Z:\Middletown\Buckeye\As-Builts\As-Builts\AB-36.dgn PLOT DATE: 2/17/2010